

SUBLEASE


Fifth Street Center

525 West Fifth Street
Covington, Kentucky 41011



1,696 SF Available

- Suite 230; see attached floor plan
- Space was completely remodeled 6/09
- Lease expires August 31, 2012
- Abundant, on-site free parking
- Immediate access to I-75/71
- Conference center on-site
- 5 minutes to downtown Cincinnati
- Furniture available
- Walk to Mainstrasse/Covington restaurants/shops

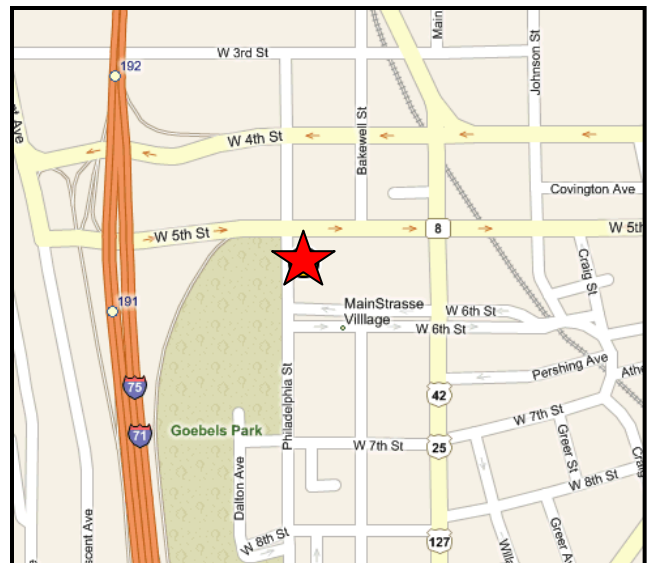

CCIM Individual Member

SIOR Individual Memberships,
Society of Industrial &
Office Realtors



Carey Laumer
Commercial Realty

8220 NorthCreek Drive, Suite 310
Cincinnati, OH 45236

Exclusive Agent:
Michele Laumer, CCIM
(513) 745-9060 Office
(513) 236-5178 Mobile
Michele@clcrealty.com
www.clcrealty.com

Suite 230
As-Built Floor Plan
1,696 USF

